






空調対象範囲

平面図 1/300
→ 消火器設置を示す。

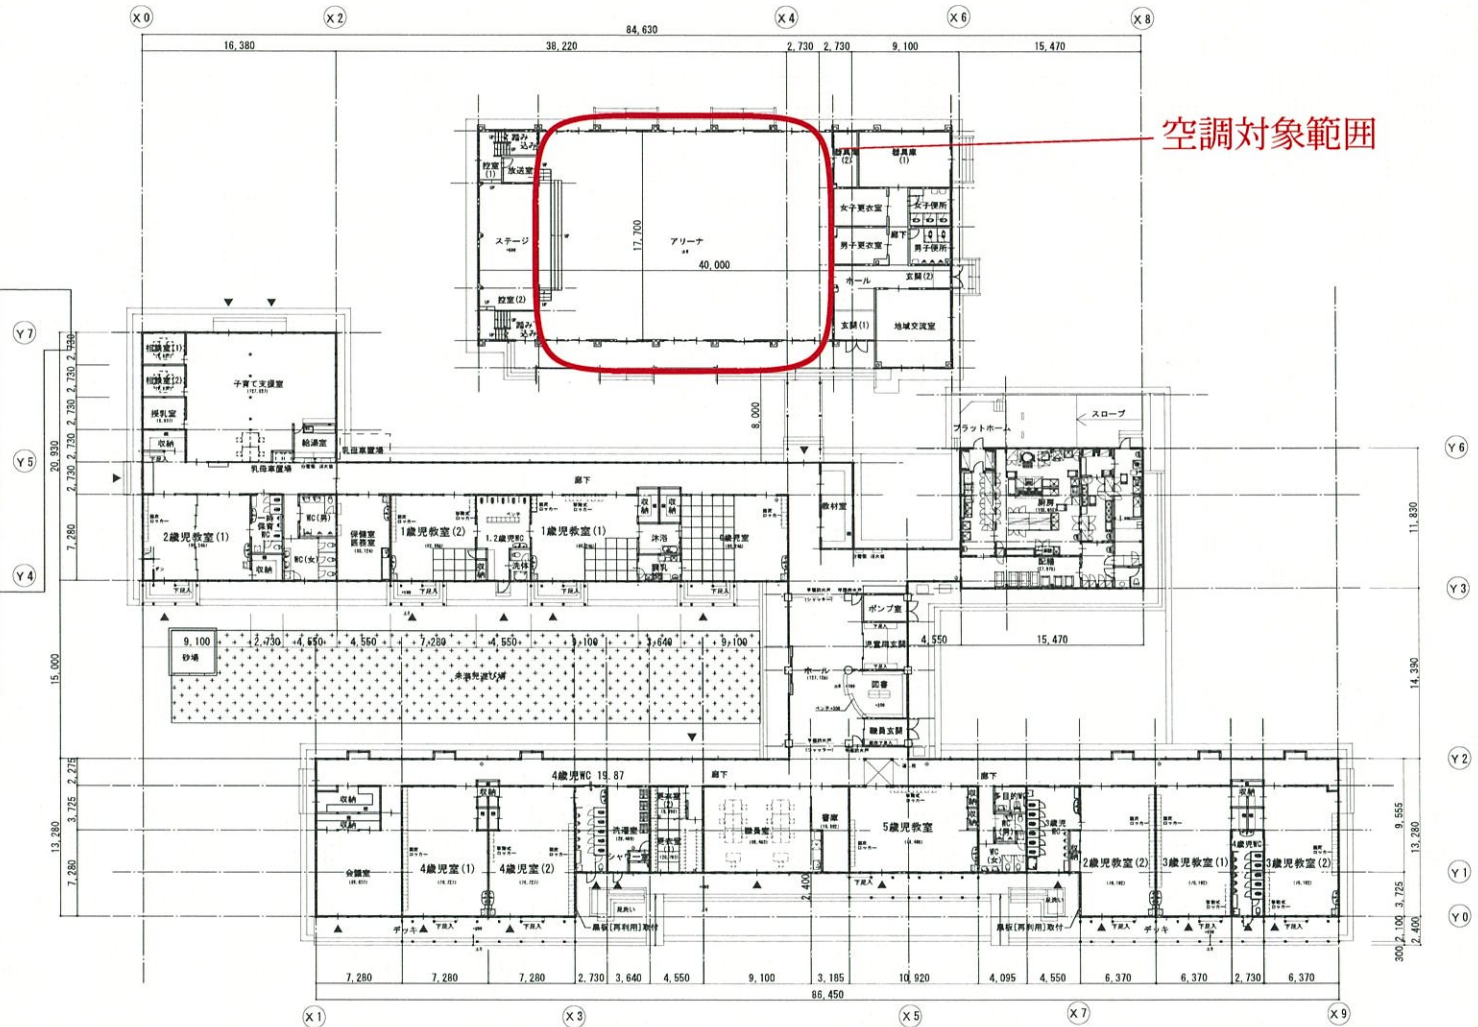


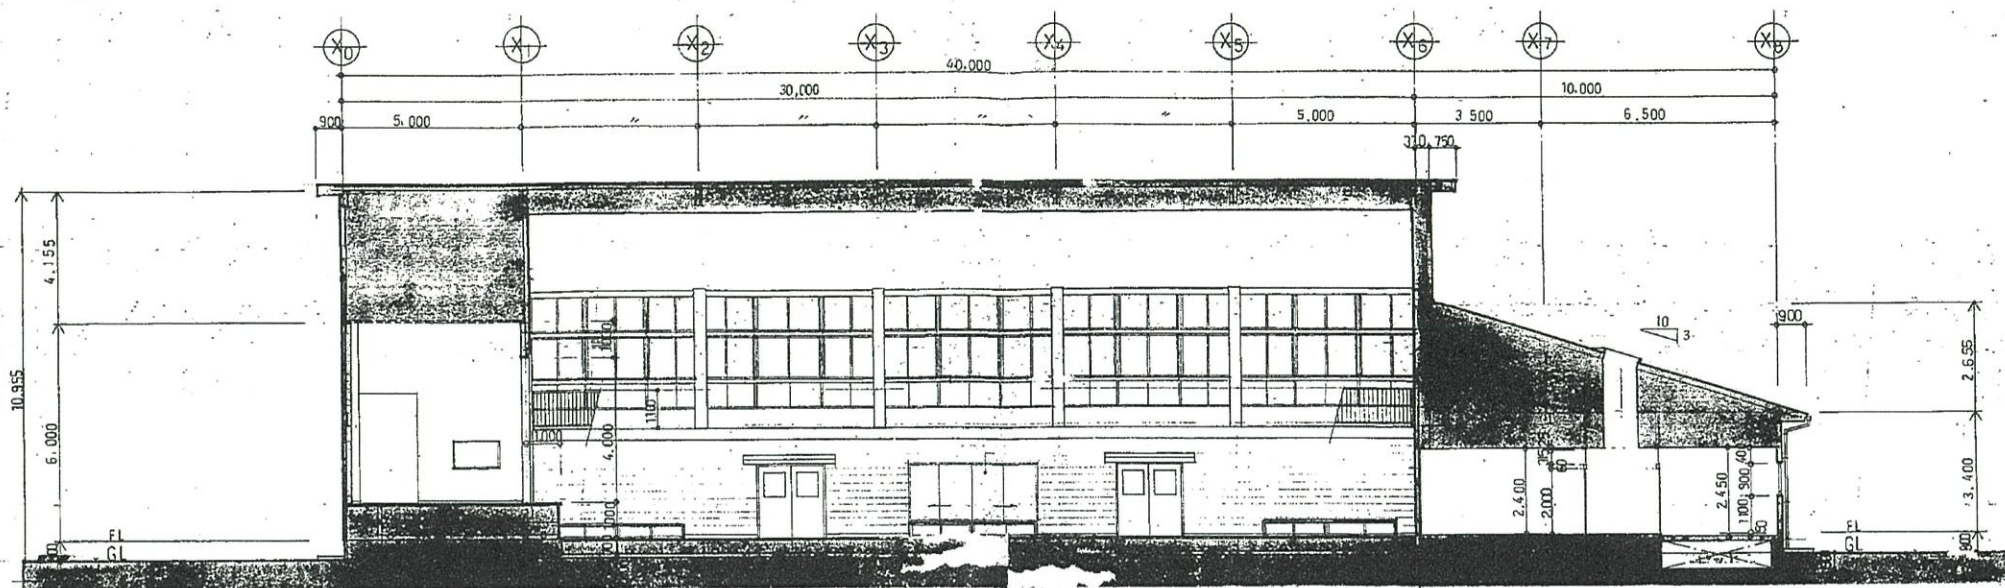


断面图 S.1/100

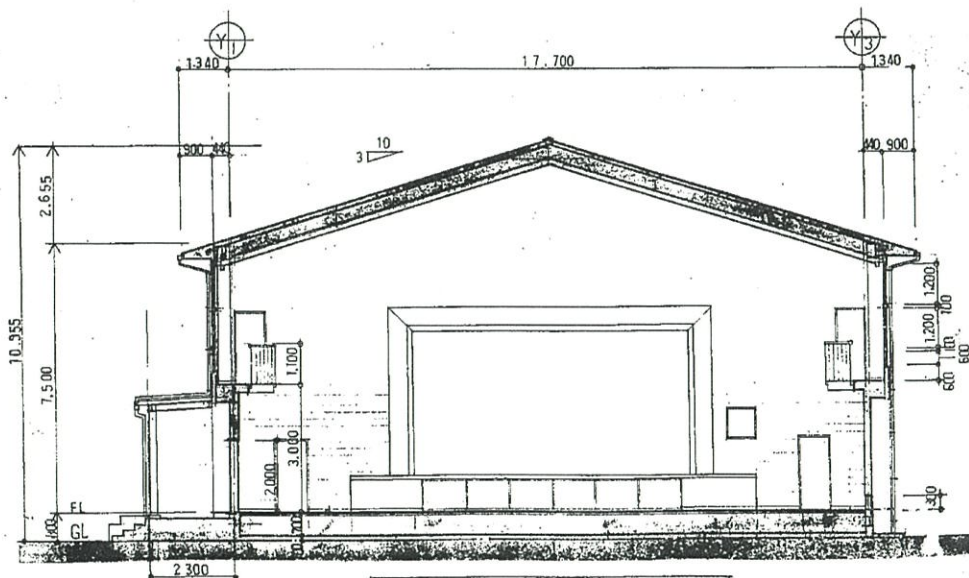


断面图 S.1/100

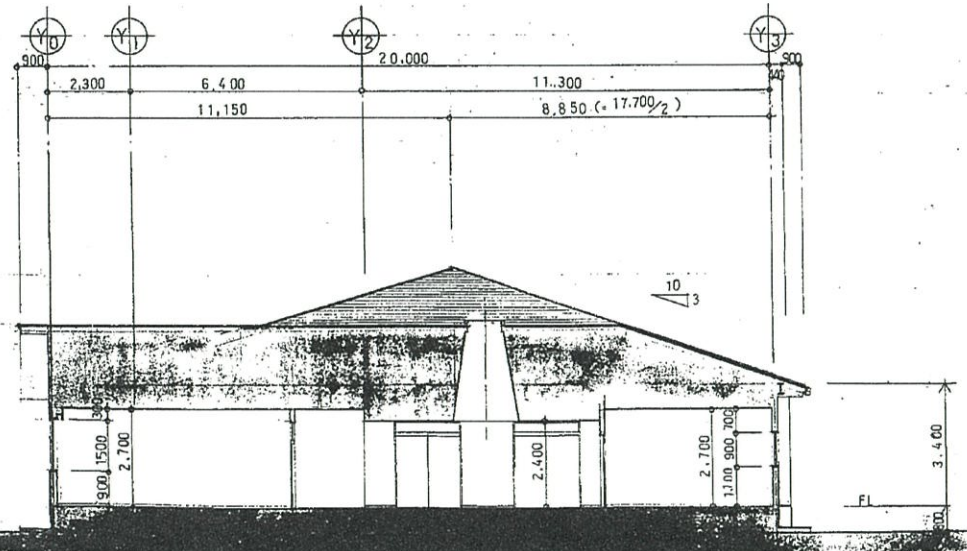


断面图 S.1/100

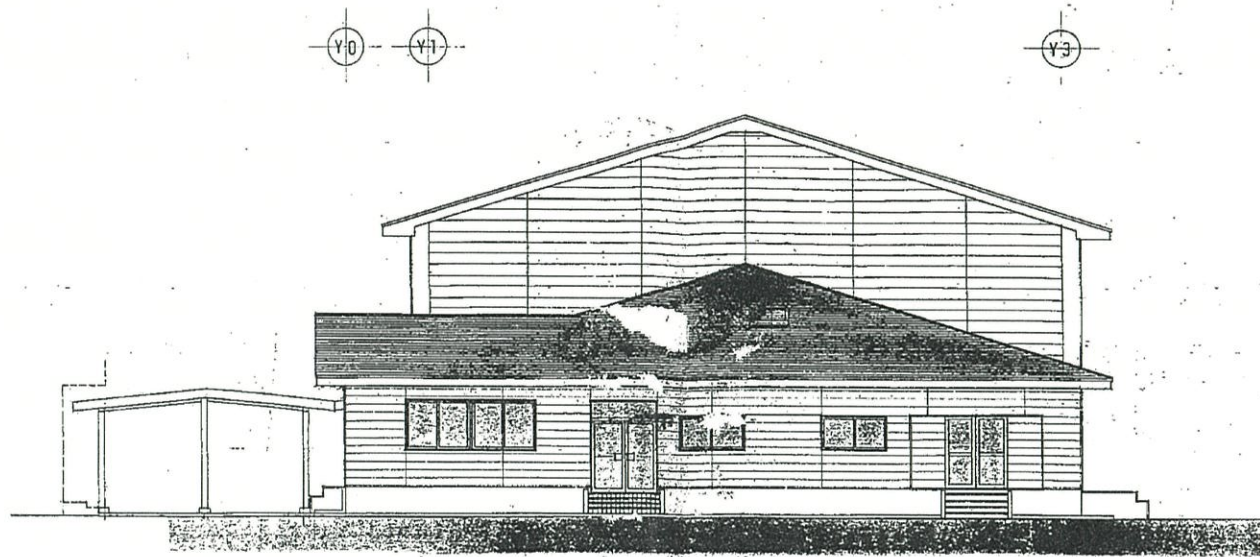

東立面図 S.1/100

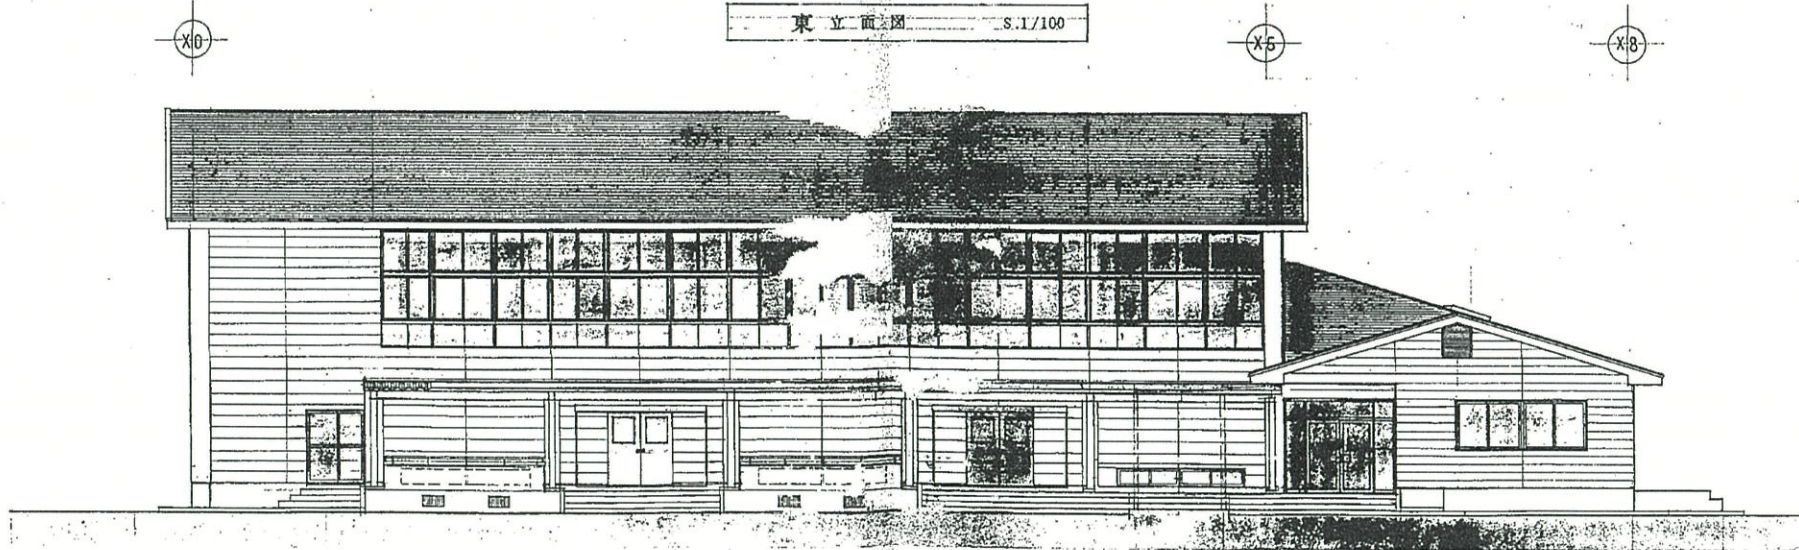

南立面図 S.1/100

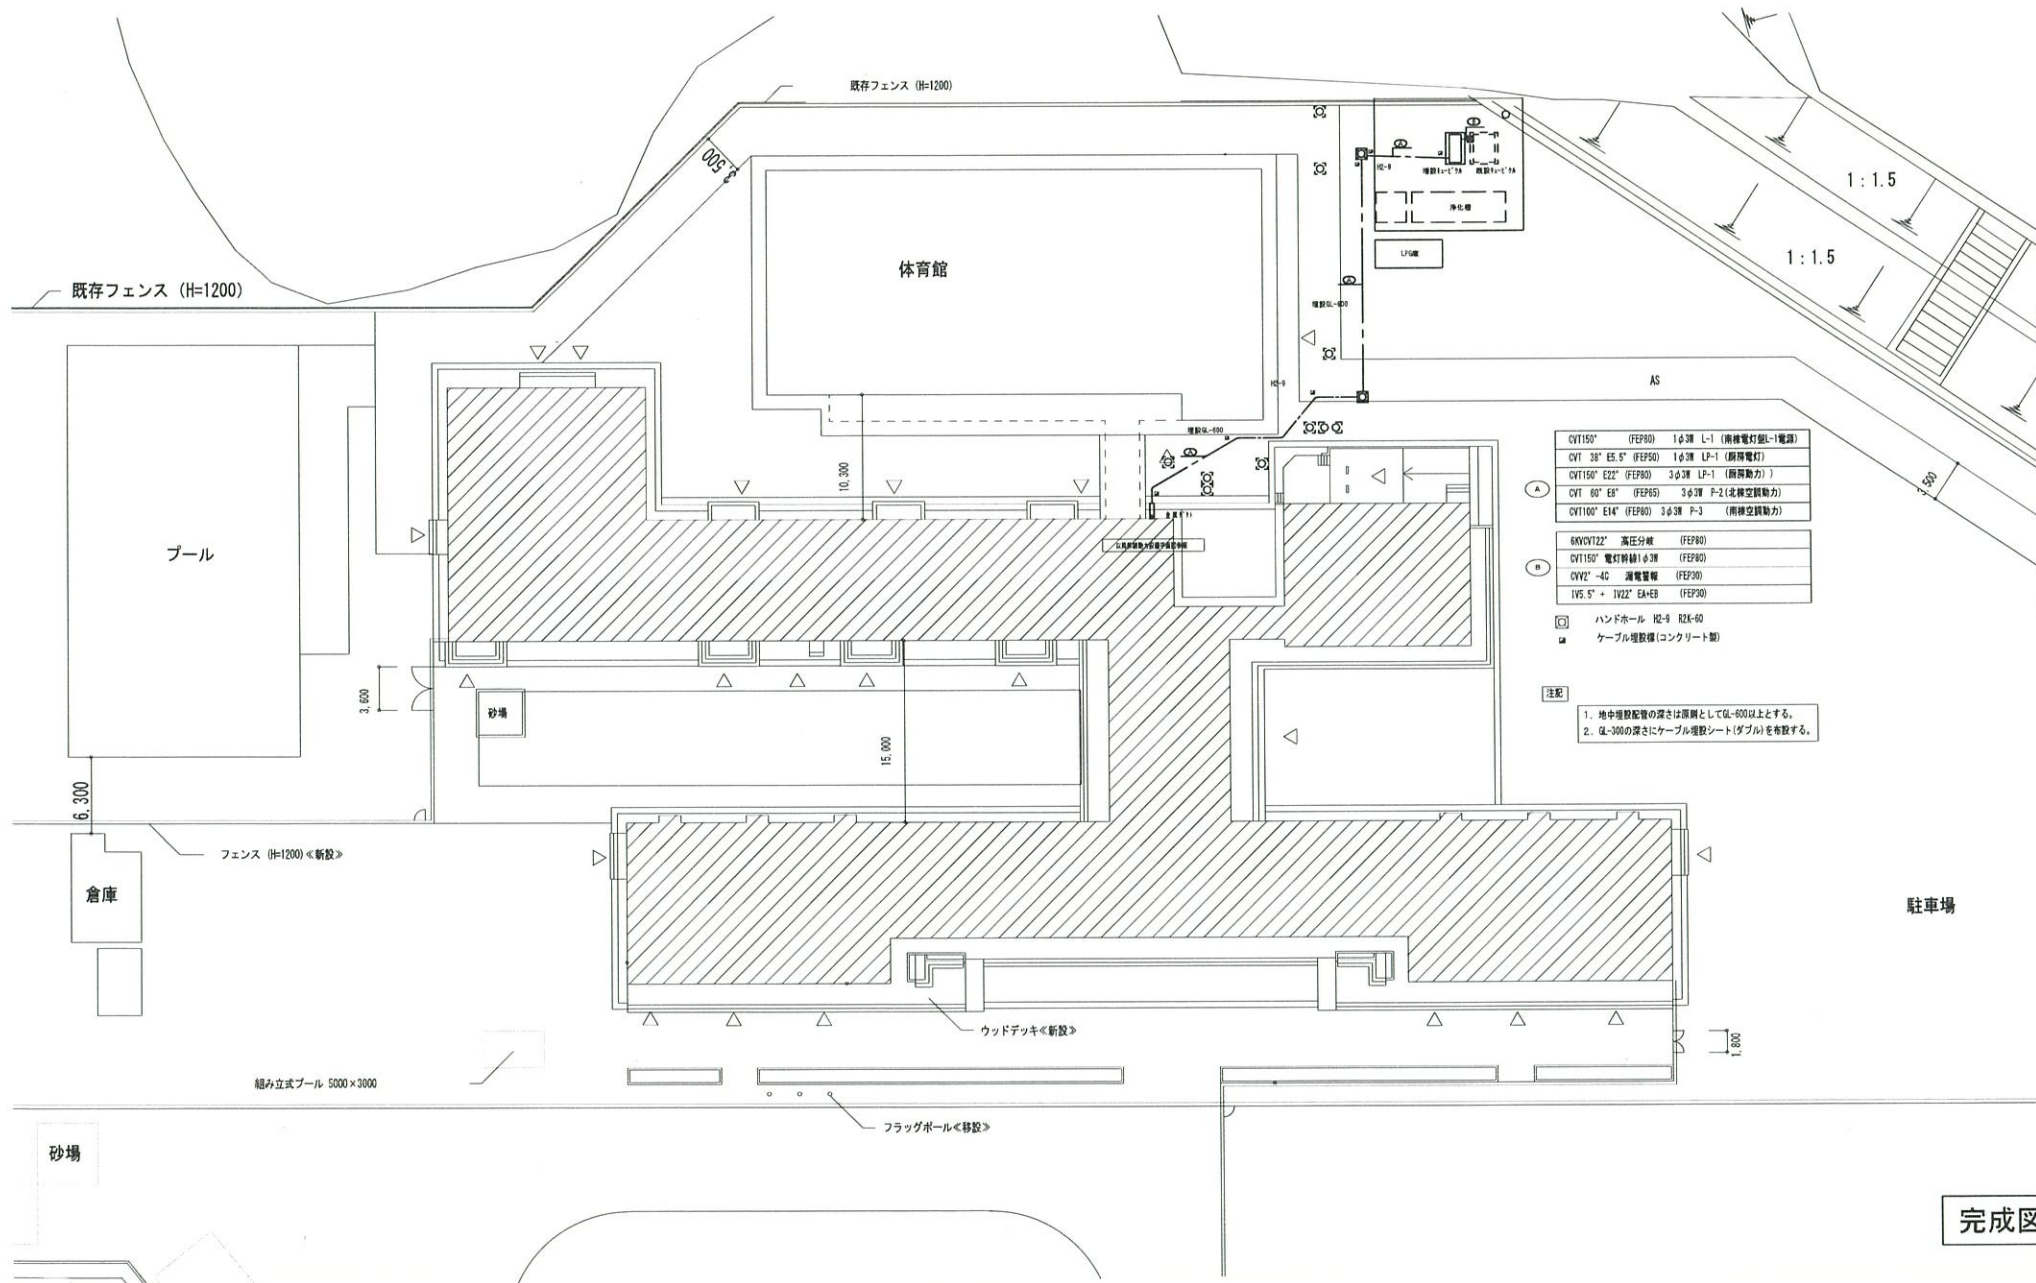


CVT150° (FEF80)	1φ3W L-1 (高圧電灯用L-1電線)
CVT 38° ES.5° (FEF50)	1φ3W LP-1 (高圧電灯)
CVT150° E22° (FEF80)	3φ3W LP-1 (高圧電灯)
CVT 60° ES° (FEF65)	3φ3W P-2 (北線空調動力)
CVT100° E14° (FEF80)	3φ3W P-3 (南線空調動力)

8AVCVT22° 高圧分岐 (FEF80)
CVT150° 電灯幹線1φ3W (FEF80)
CVT2° ~4C 漏電警報 (FEF300)
1V5.5° + 1V22° EA+EB (FEF300)

- ハンドホール RZ-9 RZK-60
- ケーブル埋設機 (コンクリート製)

【注記】
 1. 地中埋設配管の深さは原則として60-600以上とする。
 2. 60-300の深さにケーブル埋設シート(ダブル)を布設する。

 完成図



機軸記号	取出係任盤名称	行灯名称	電圧	電氣容量 (kW)	ケーブル	接地線
L-1-1	低圧行灯盤	L-2-2	1-φ300/100V	14.8VA	CV100"	1V14"
L-1-2	L-2-3	"	"	47.8VA	CV100"	1V14"
L-1-7	低圧行灯盤	L-P-3	"	10.13kVA	CV138"	1V5.5"
L-1-8	低圧行灯盤	L-1-1	"	29.8VA	CV1150"	1V22"
P-2-1	低圧動力用N.O. 2	L-P-1	3-φ200/200V	56.3kVA	CV1150"	1V22"
P-2-2	"	P-2-2	"	22.8kVA	CV1600"	1V8"
P-2-3	"	P-2-3	"	23.8kVA	CV1100"	1V14"

A	CVT 38" E5.5" (FEP50)	1 φ 3W LP-1
	CVT150" E22" (FEP80)	3 φ 3W LP-1
	CVT80" E8" (FEP65)	3 φ 3W P-2
	CVT100" E14" (FEP80)	3 φ 3W P-3
BKVCVT22" 高圧分岐 (FEP80)		
B	CVT22" LI-7	1 φ 3W
	CV22" -4C	漏電警報 (FEP80)
	IV14" + IV22" EA+EB	



完成图

主回路代り接続図		電圧降下 (A1-E-LCB)		電圧降下 (B1-E-LCB)		電圧降下 (C1-E-LCB)		電圧降下 (D1-E-LCB)		電圧降下 (E1-E-LCB)		電圧降下 (F1-E-LCB)		電圧降下 (G1-E-LCB)		電圧降下 (H1-E-LCB)		電圧降下 (I1-E-LCB)		電圧降下 (J1-E-LCB)	

制御盤名称 (型式)	電圧 (V) 幹線記号	主開閉器 (AF/AT) 及び室内給線	機 器				主回路	分岐回路	3 P	現場盤				受信機 (警報回路)				インター		運動	備 考
			記号・回路番号	名称	容量 (KW)	台数				設置箇所	幹線記号	操作	運転表示	異常	水位	操作	運転表示	異常	水位		
LP-1 動力盤 (電灯盤と一体型) 屋内自立型	AC 3φ3W200V P2-1		(201)	包丁・まな板消毒保管機	3.10	1	1階	A1	3P50/20												
			(202)	消毒保管機	4.20	1	1階	A1	3P50/50												
			(203)	包丁・まな板消毒保管機	3.10	1	1階	A1	3P50/20												
			(204)	消毒保管機	6.40	1	1階	A1	3P50/50												
			(205)	ビューアウォシャー	2.36	1	1階	A1	3P50/20												
			(206)	消毒保管機	12.00	1	1階	A1	3P100/100												
			(207)	消毒保管機	12.00	1	1階	A1	3P100/100												
			(208)	消毒保管機	6.40	1	1階	A1	3P50/50												
			(209)	消毒保管機 (調乳室)	2.10	1	1階	A1	3P50/20												
			(210)	断熱用換気扇 VF-5	1.5	1	1階	D2-c	3P50/20	○	○	○									
			(211)	断熱用換気扇 VF-5	1.5	1	1階	D2-c	3P50/20	○	○	○									
			(212)	予備				A2	3P50/												
			(213)	操作電源				I	3P50/20												
	</																				

完成図